


Grading Plan Approved  
as shown and/or noted  
**THOMAS P. GILLES, P.E.**  
Lake County Engineer

By \_\_\_\_\_ Date 10/15/99

**ROOF DRAINS  
SHALL DISCHARGE  
TO SPLASH BLOCKS.**

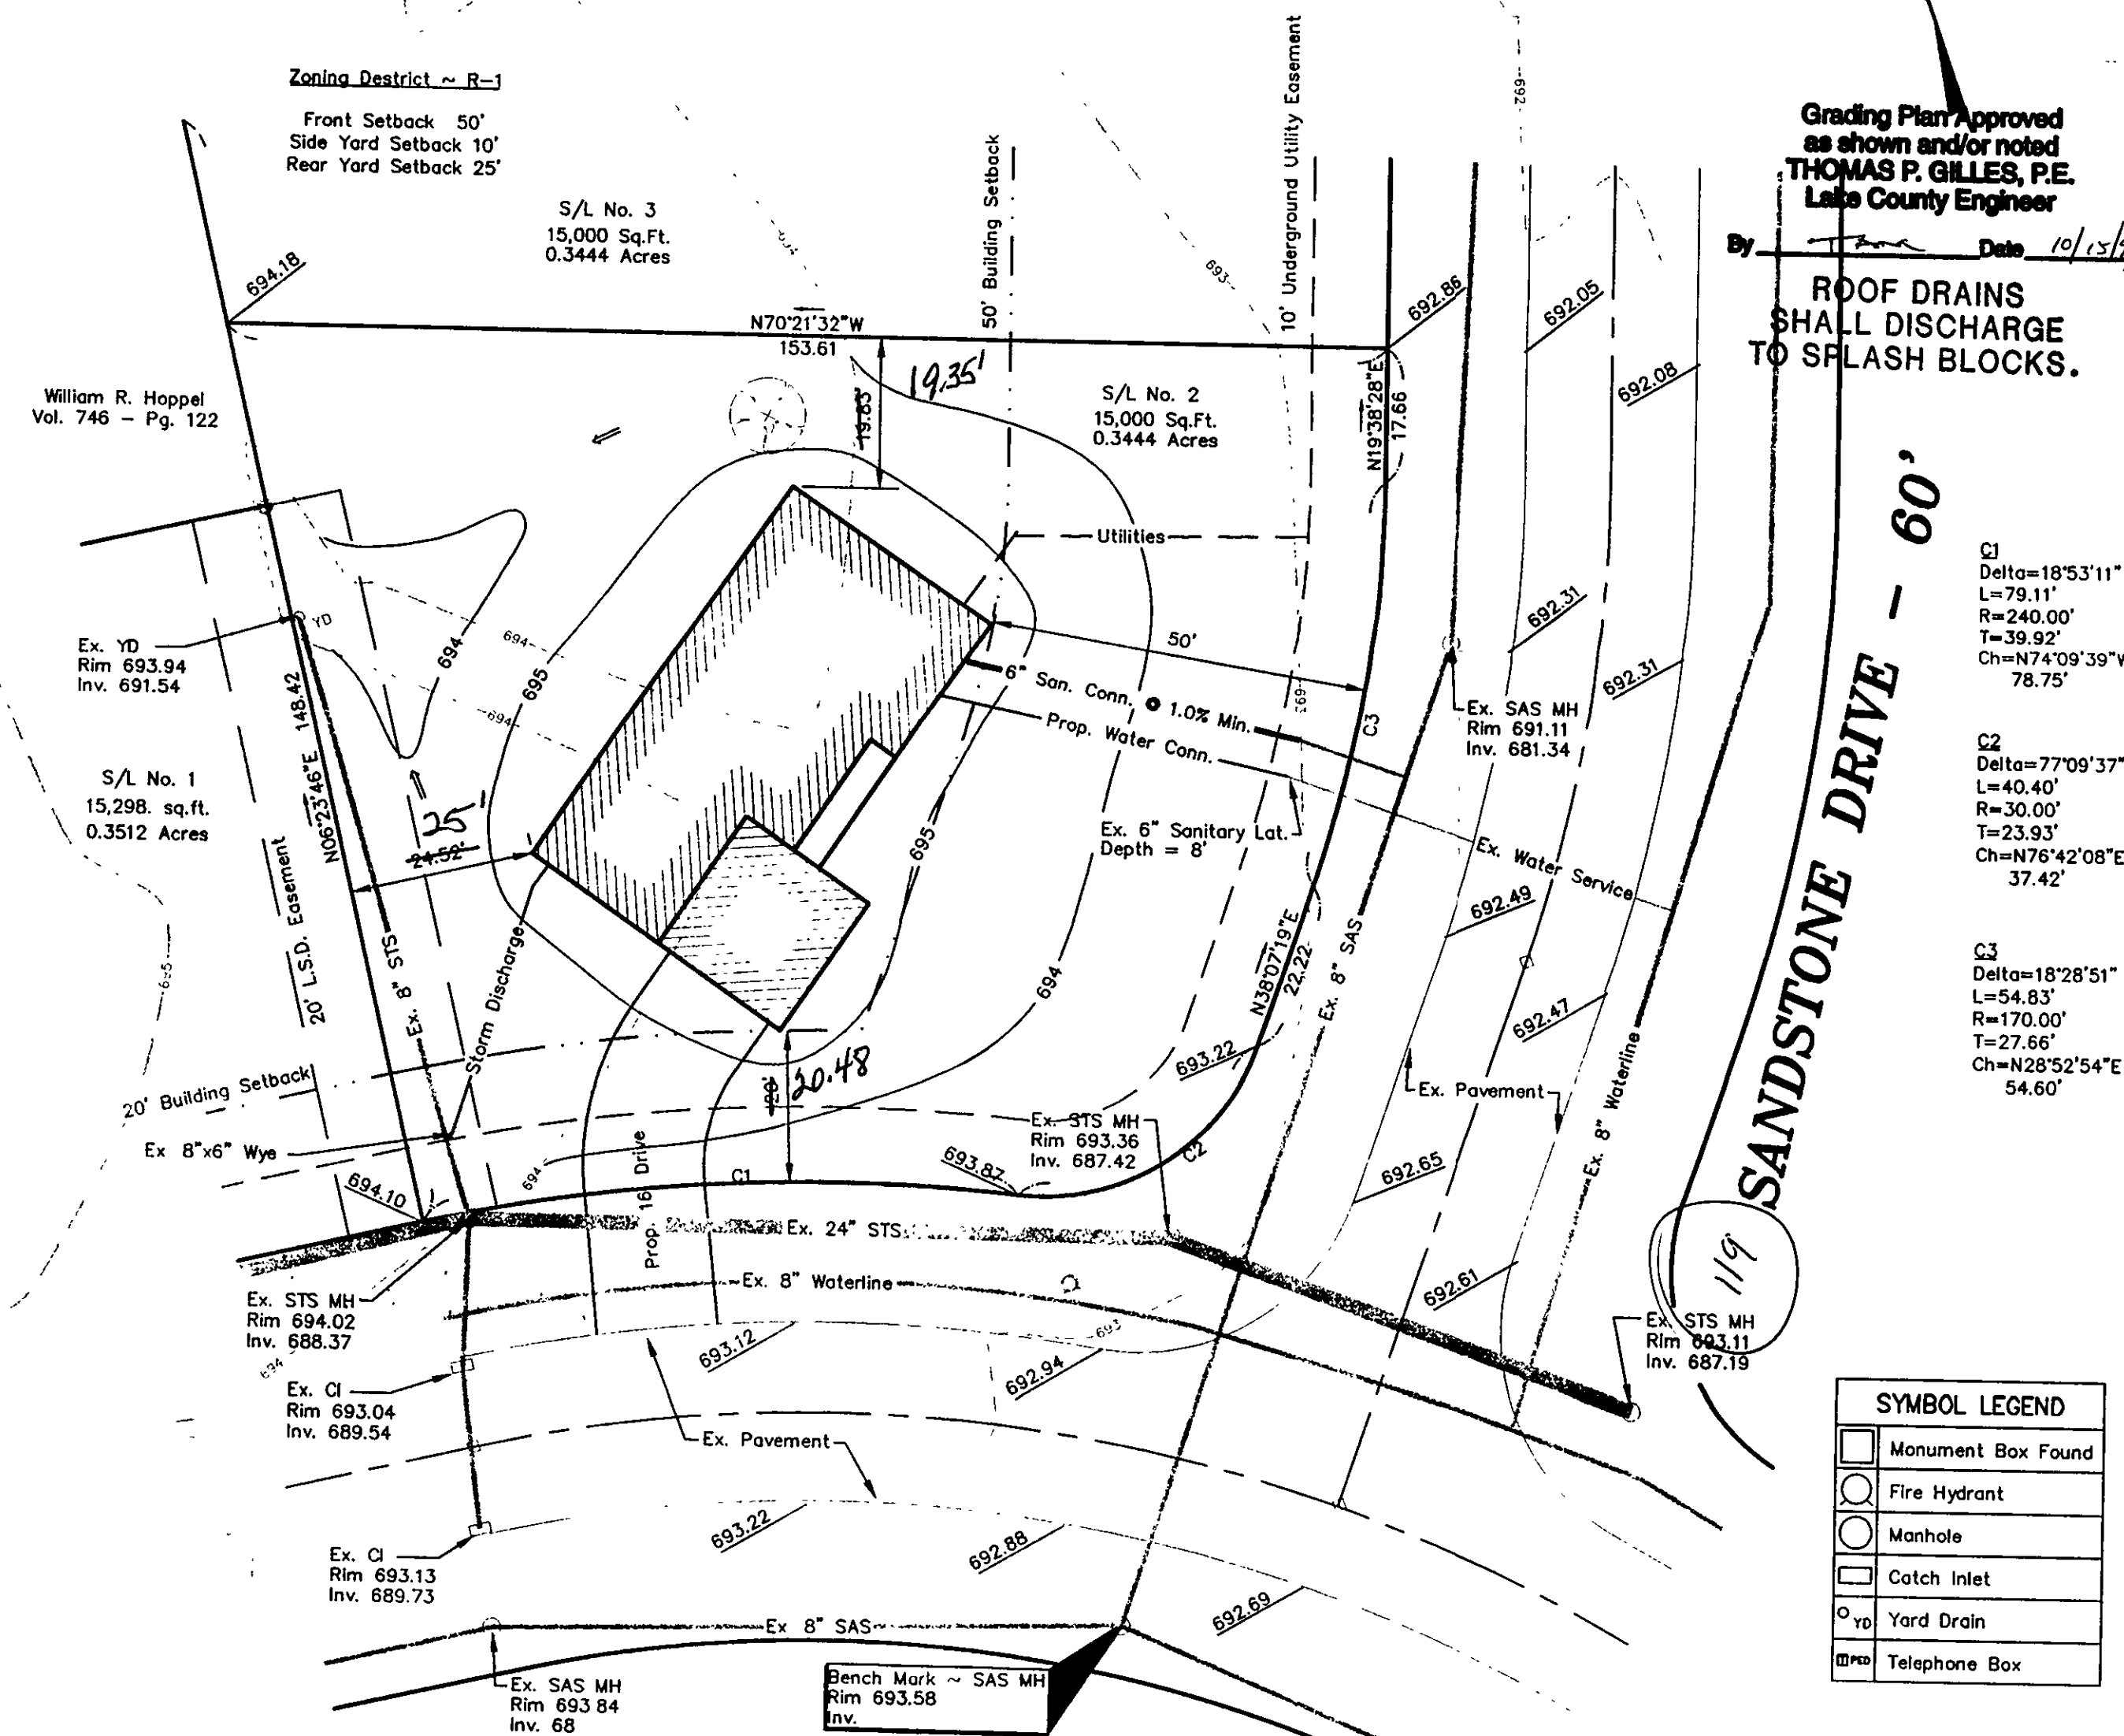

**SANDSTONE DRIVE - 60'**

**BANNERSTONE DRIVE - 60'**

SYMBOL LEGEND	
	Monument Box Found
	Fire Hydrant
	Manhole
	Catch Inlet
	Yard Drain
	Telephone Box

# SITE PLAN

for : R.L. MOORE CLIENT  
7121 Ravenna Rd. ADDRESS  
Concord Ohio 44077 CITY STATE ZIP

2 SUBLOT No. Eastern Woodlands Sub. SUBDIVISION NAME VOL. PAGE  
Painesville Twp. Ohio CITY STATE

## Foresight Engineering Group

440 286-1010  
440 286-1034 fax  
320 Center Street, Unit F  
Chardon, Ohio 44024

**Engineers &  
Surveyors**


### DESIGN CERTIFICATION

This Site Plan was prepared by Foresight Engineering Group, Inc., and is correct to the best of my knowledge and belief.

Thomas P. Gilles  
NAME

### CHECK LIST

LOT DIMENSIONS & BEARINGS  
TIE TO NEAREST STREET  
SUBLOT No. (PARCEL No.)  
SURROUNDING OWNERS  
BUILDING DIMENSIONS  
SETBACK, SIDEYARD, REARYARD  
FINISH GRADES  
DRIVE & APRON TYPE, WIDTH, THICKNESS  
SIDEWALK TYPE, WIDTH, THICKNESS  
CULVERT TYPE, DIAM., LENGTH  
WATER MAIN SIZE, LOCATION  
SAN. SEWER SIZE, % GRADE, LOC.  
SAN. MH. CAST. ELEV., INV. ELEV.  
SAN. CONN. SIZE, % GRADE, LOC.  
STORM SEWER SIZE, % GRADE, LOC.  
STORM MH. CAST. ELEV., INV. ELEV.  
PAVT TYPE, GRADE, CURBS  
GAS LINE LOC., SIZE  
SEPTIC SYSTEM & DUPLICATION  
WELL LOCATION & ISOLATION RADIUS

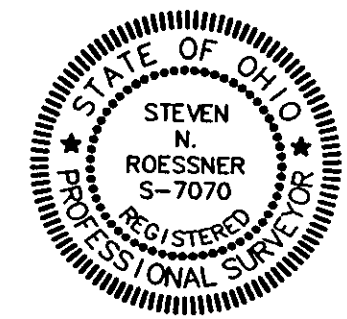

STATE SEAL

### "AS BUILT" CERTIFICATION

I hereby certify that the circled information is existing as obtained on the site 19 and is correct to the best of my knowledge and belief.

NAME

SCALE : 1" = 20'	1
FILE NAME: I:\Rim19916\SL-2	2
DATE : October 14, 1999	3

**BENCHMARK:** SAS Manhole Rim elev. = 693.58

"I, the undersigned hereby certify that this topography, indicated by 6", 1' or 2' contours, and the elevations shown hereon represent an actual field survey made by Foresight Engineering Group, Inc. on the 12 day of March 19 99 and that the elevations were taken at appropriate intervals and that as of that date they existed as indicated hereon."

Thomas P. Gilles  
NAME



**EXISTING UNDERGROUND UTILITIES NOTES:**  
The location both horizontal and vertical of the underground utilities shown hereon, have been obtained by a diligent and comprehensive search of available records. Verification by field observation, has been conducted where practical. However, Foresight Engineering Group, Inc. does not guarantee the completeness nor accuracy thereof.

APPROVED  
PAINESVILLE TOWNSHIP  
ZONING DEPARTMENT  
19990334  
DR